



File Name: C:\WORKING\DM506947\SEKC6007.DGN  
 User: DALE.LARKEE  
 Time Plotted: 09:18:38 AM  
 Date Plotted: 12/22/2006  
 Pen Table: S:\MICROSTATION\PLOTTABLES\T-REX-GRAY.TBL

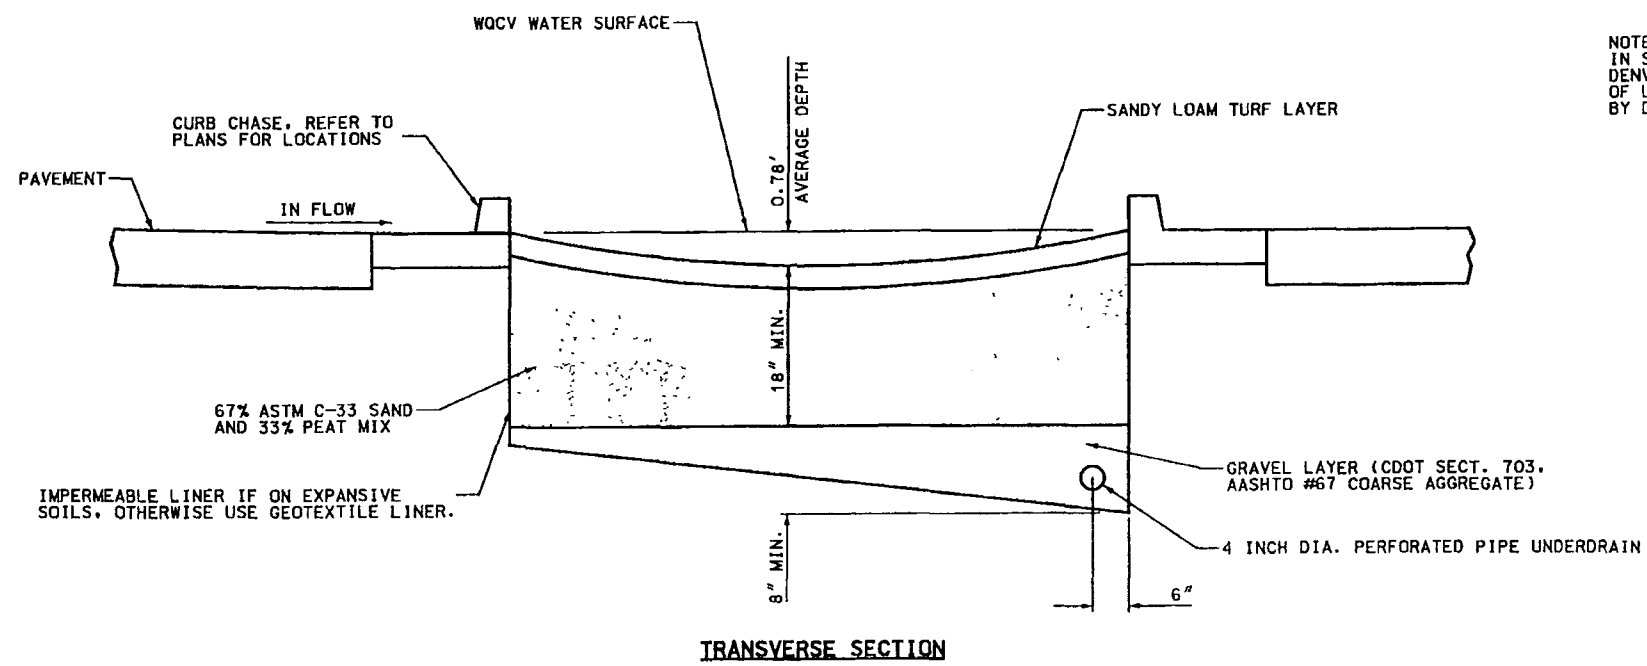

NOTE:  
 IN SPECIFIC CASES OF ISLANDS WHICH FALL WITHIN  
 DENVER WATER DEPARTMENT EASEMENTS, 4" MIN.  
 OF LANDSCAPE ROCK OR RIVER ROCK AS APPROVED  
 BY DENVER WATER SHALL BE THE ISLAND FILL MATERIAL.

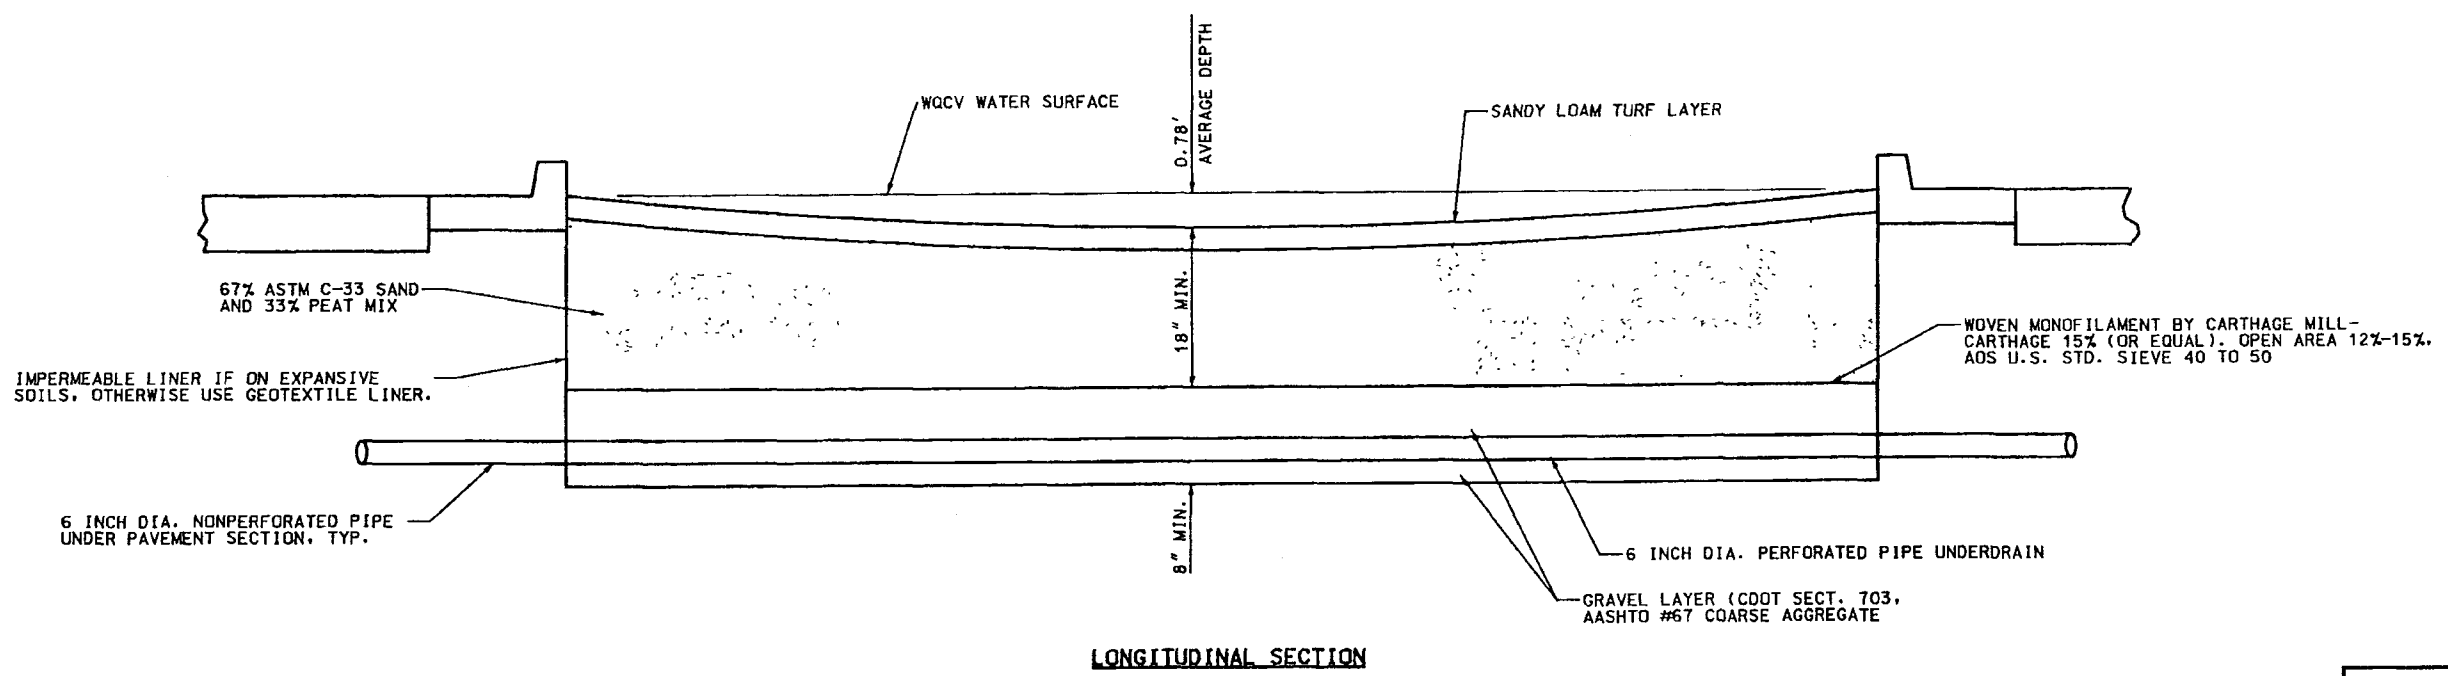

**1 POROUS LANDSCAPE DETENTION**  
 NOT TO SCALE

DESIGNED BY: JAY		ISSUE RECORD		DATE
NO.	DESCRIPTION			
A	65% IN-PROCESS DESIGN SUBMITTAL	02AUG02		
B	100% FINAL DESIGN SUBMITTAL	03SEP02		
1	APPROVED FOR CONSTRUCTION	18NOV02		
2	APPROVED FOR CONSTRUCTION NDC #401	12MAR03		
AB	AS-BUILT	22DEC06		

  
 METRO DENVER / COLORADO  
  
 Southeast Corridor Constructors  
 7200 South Alton Way  
 Englewood, CO 80112

  
 ARCHITECTS  
 ENGINEERS  
 PLANNERS  
 1600 BROADWAY  
 SUITE 1300  
 DENVER, COLORADO 80202  
 PH (303) 839-8500 FAX (303) 839-8800

SOUTHEAST CORRIDOR MULTI-MODAL PROJECT  
 AREA 1.3  
 COLORADO STATION  
 POROUS LANDSCAPE DETENTION

PROJECT NO./CODE	NH 0252-299 11584
FILE NAME	SEKC6007
DRAWING NUMBER	LS157

AS-BUILT